

Valley Terrace Sub'd
1st Addition
No houses
Sheet 18

no houses finished.
Sheet 18
RECORD PLAN

VALLEY TERRACE SUBDIVISION 1ST ADDITION


LOCATED IN
VIRGINIA MILITARY SURVEY #2534
HUNTINGTON TWP., BROWN CO., OHIO
CONTAINING 11.769 ACRES
SCALE 1"=100'

PREPARED BY:
GERALD S. RENSHAW
LAND SURVEYING & MAPPING
GEORGETOWN, OHIO

The within plat is a subdivision of 11.769 acres out of 29.67 acres conveyed to DAN PREWITT and VIRGIL STEWART as recorded in Book 135 Page 419 of the deed records of Brown County, Ohio.

I hereby certify that this subdivision plat of land shown is a correct representation of the land surveyed and platted and that the lots have been staked and reference monuments set.

GERALD S. RENSHAW P.S. #4872

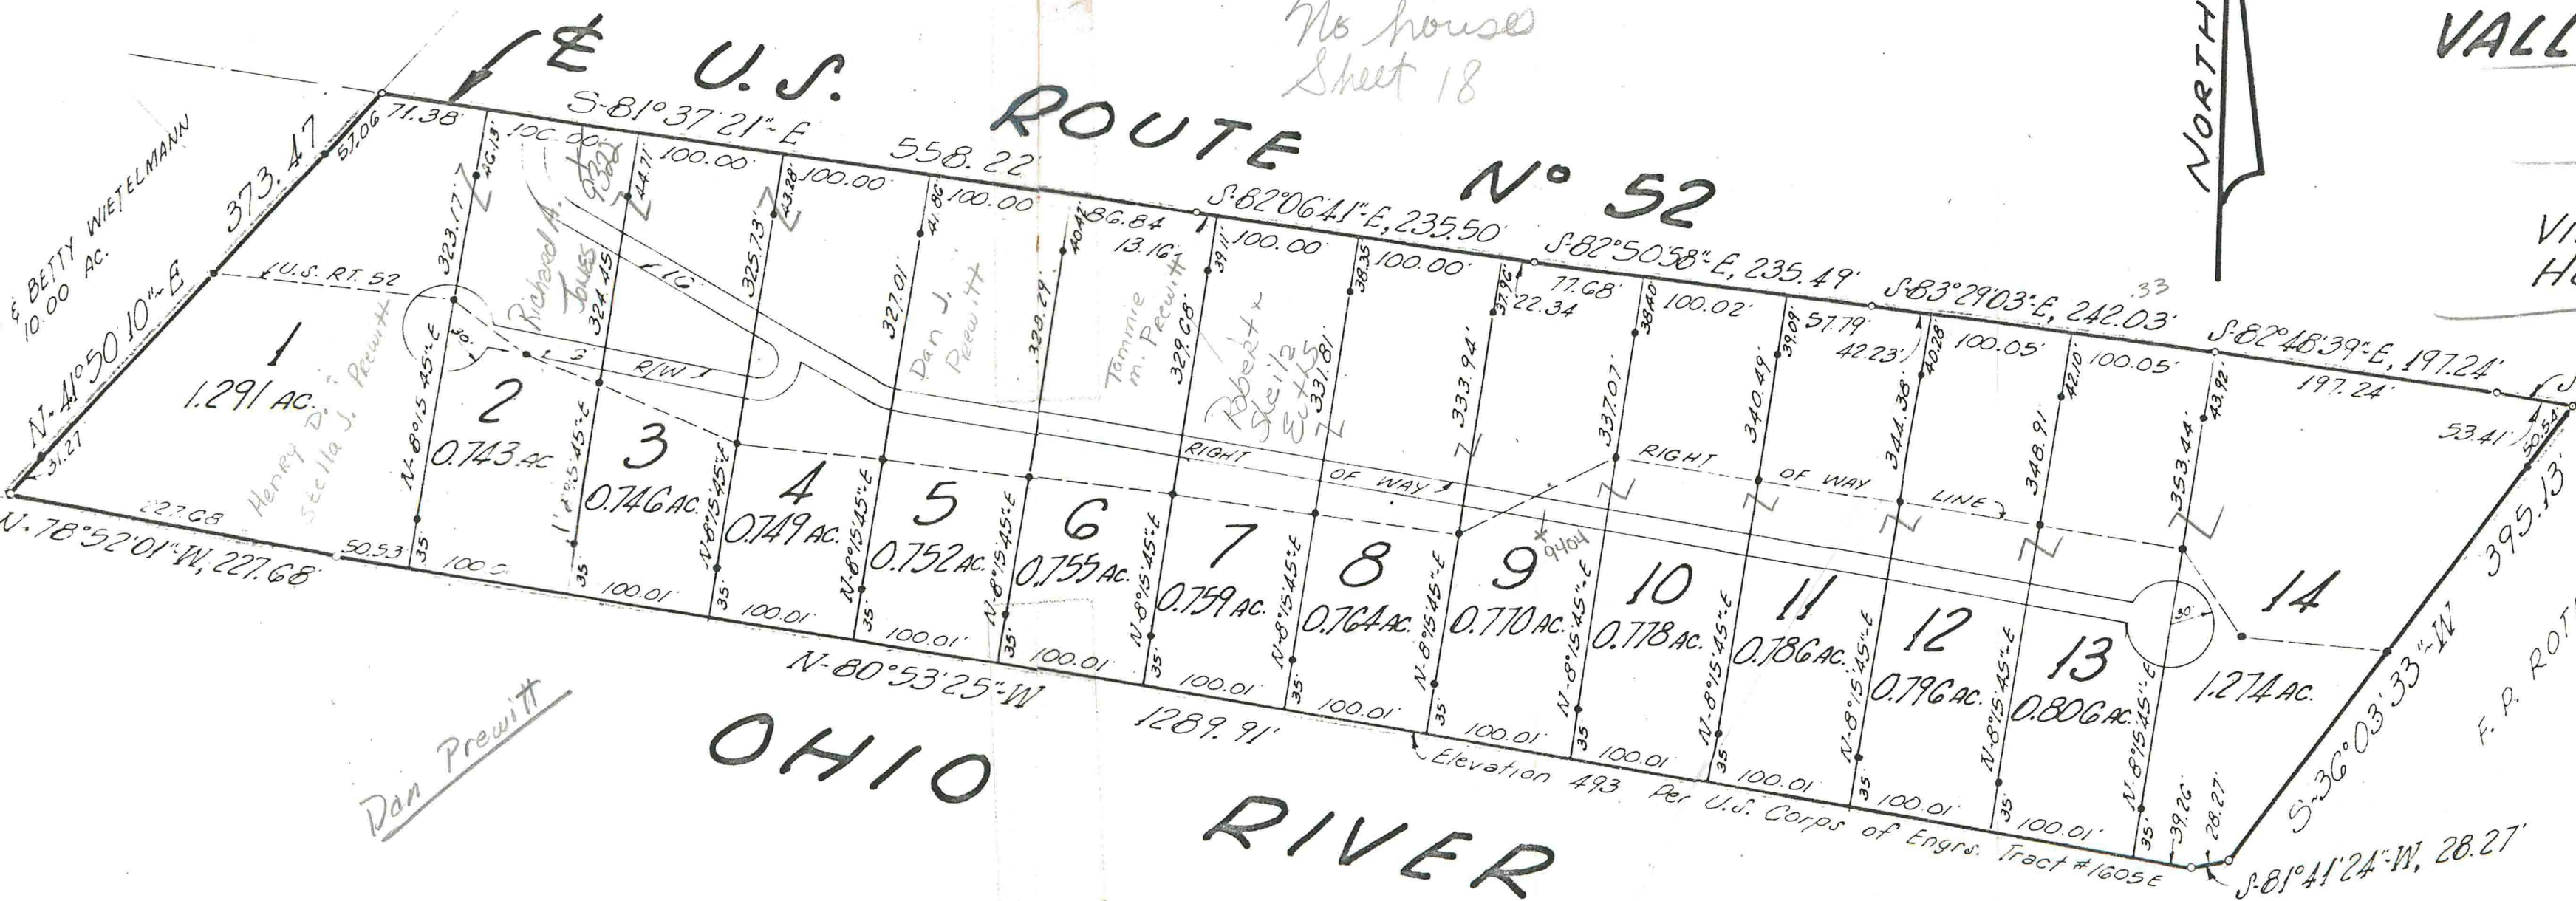

- o - Change In Boundary Course
- - Iron Pin Set
- ⊙ - Monument

DEDICATION